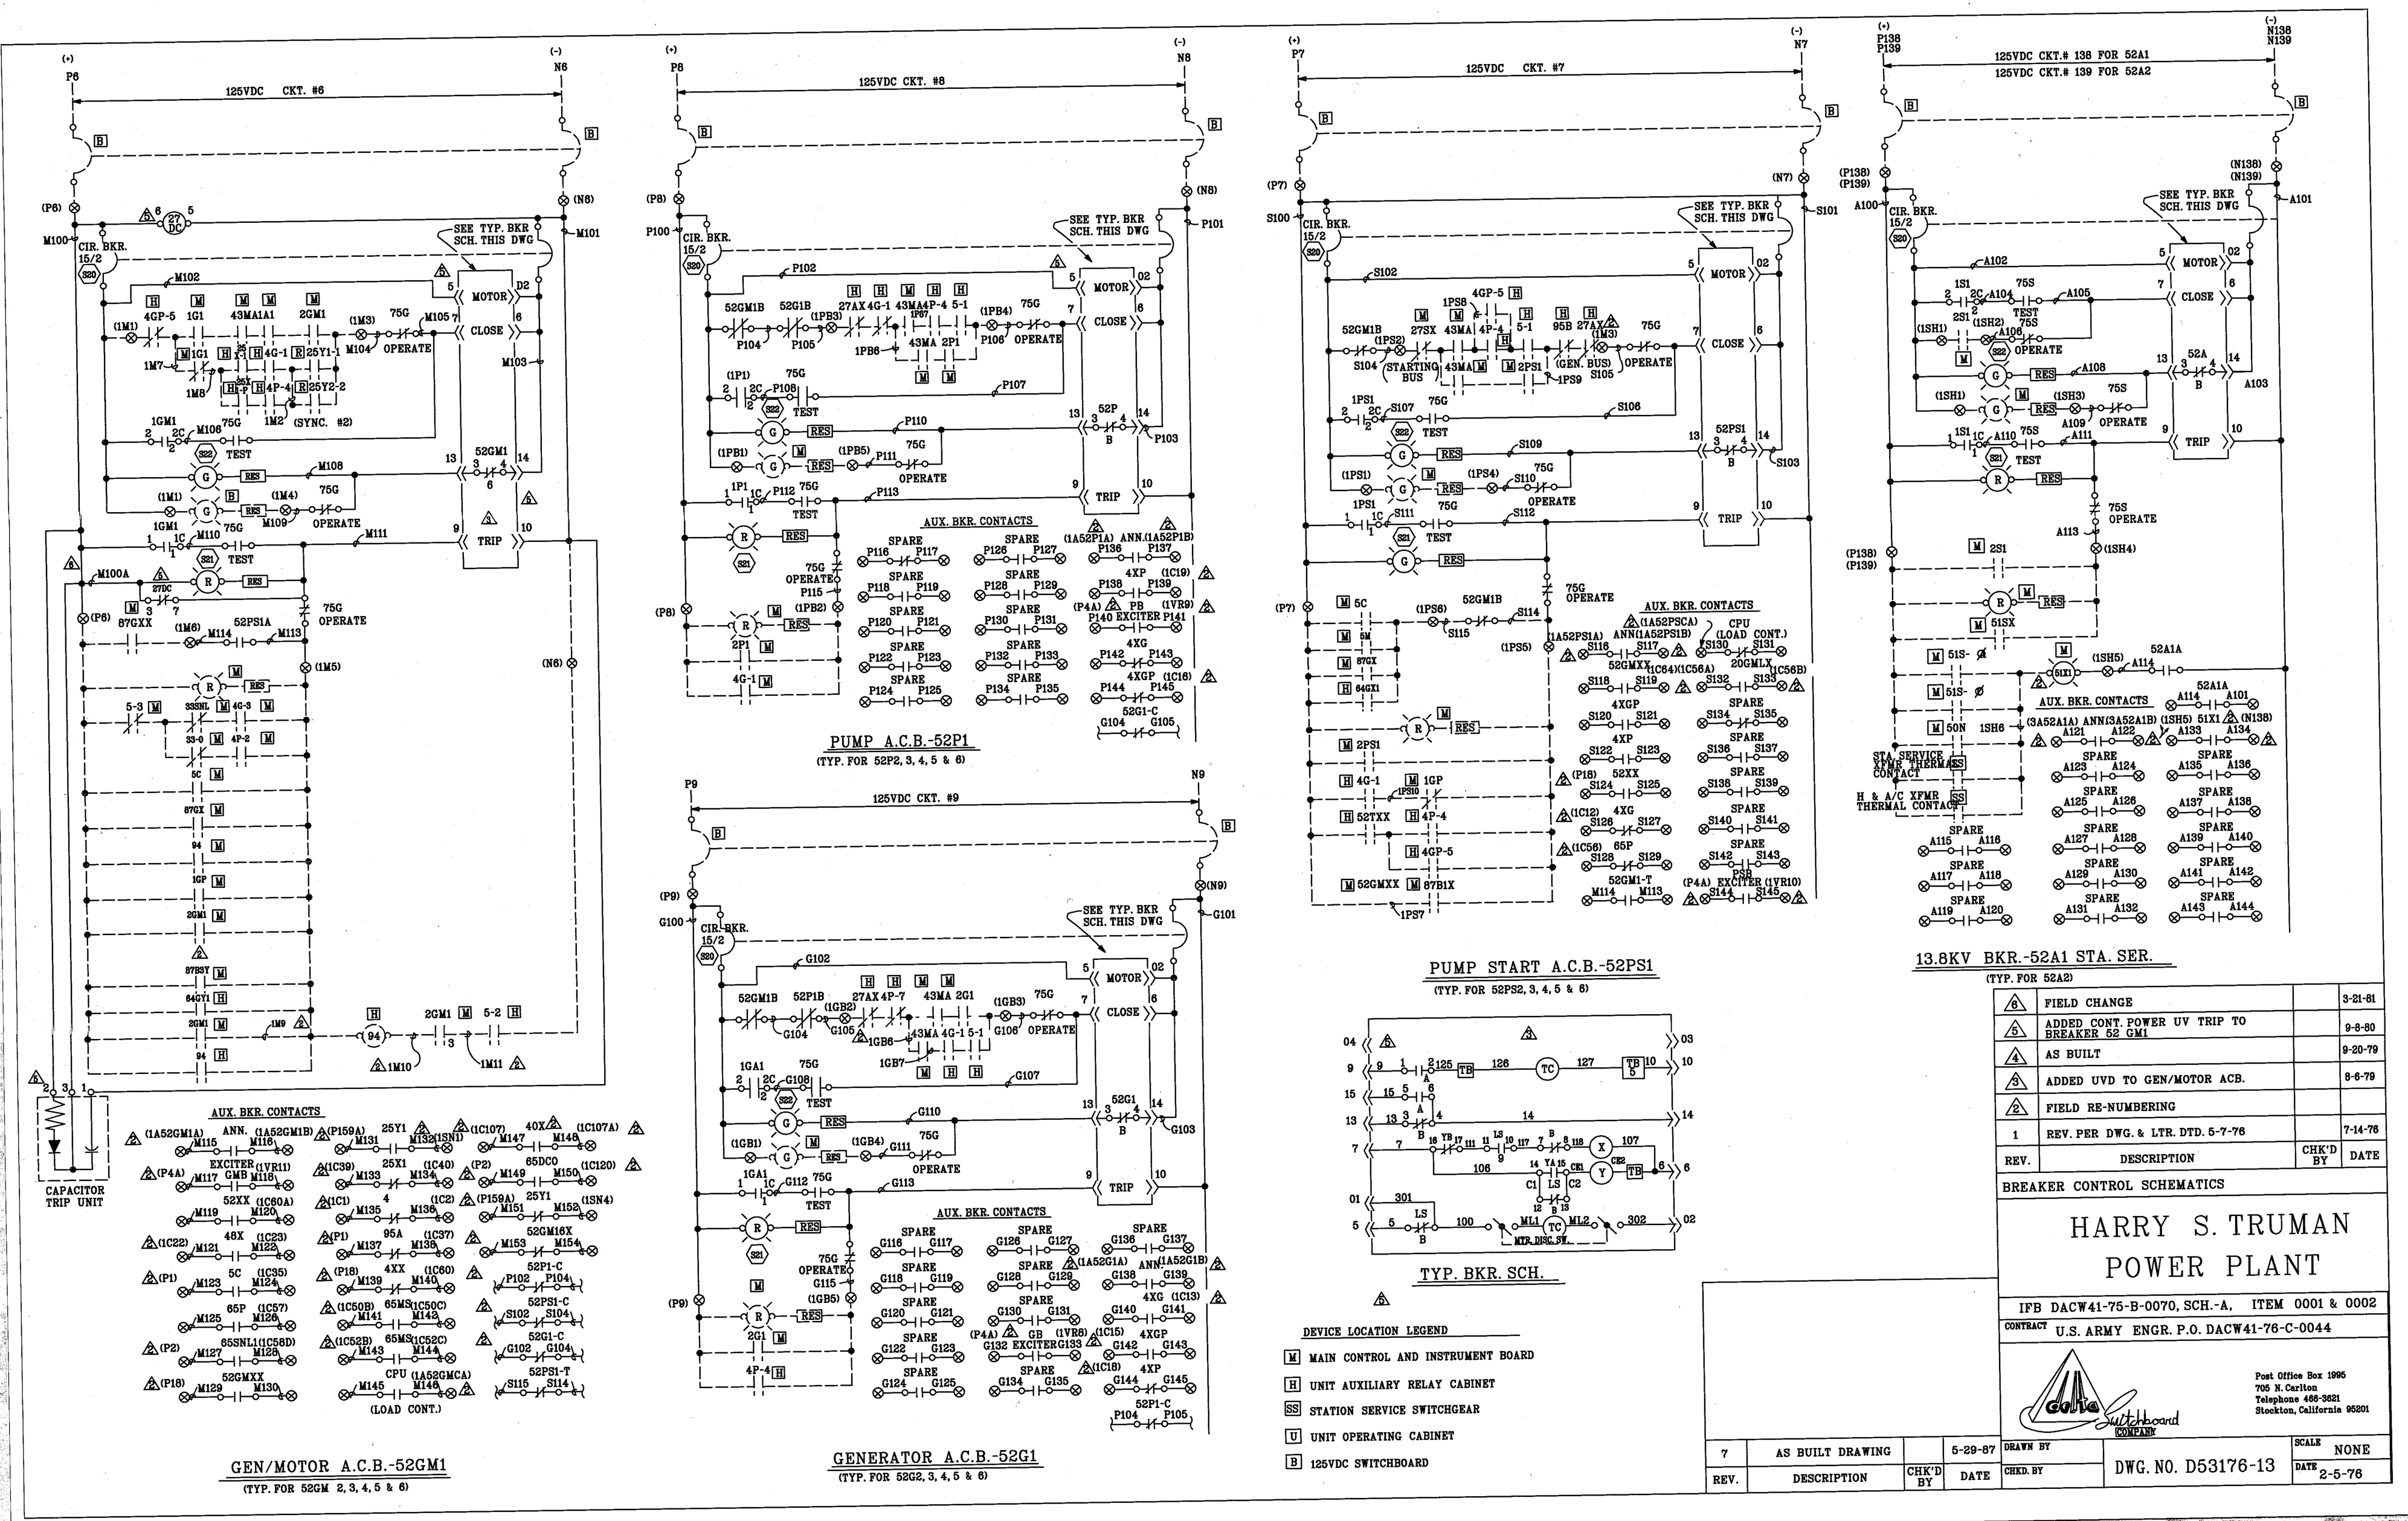

GEN/MOTOR A.C.B.-52GM1
(TYP. FOR 52GM 2, 3, 4, 5 & 6)

PUMP A.C.B.-52P1
(TYP. FOR 52P2, 3, 4, 5 & 6)

GENERATOR A.C.B.-52G1
(TYP. FOR 52G2, 3, 4, 5 & 6)

PUMP START A.C.B.-52PS1
(TYP. FOR 52PS2, 3, 4, 5 & 6)

TYP. BKR. SCH.

13.8KV BKR.-52A1 STA. SER.
(TYP. FOR 52A2)

DEVICE LOCATION LEGEND

- M MAIN CONTROL AND INSTRUMENT BOARD
- H UNIT AUXILIARY RELAY CABINET
- SS STATION SERVICE SWITCHGEAR
- U UNIT OPERATING CABINET
- B 125VDC SWITCHBOARD

REV.	DESCRIPTION	CHK'D BY	DATE
6	FIELD CHANGE		3-21-81
5	ADDED CONT. POWER UV TRIP TO BREAKER 52 GM1		9-8-80
4	AS BUILT		9-20-79
3	ADDED UVD TO GEN/MOTOR ACB.		8-6-79
2	FIELD RE-NUMBERING		
1	REV. PER DWG. & LTR. DTD. 5-7-76		7-14-76

BREAKER CONTROL SCHEMATICS

HARRY S. TRUMAN POWER PLANT

IFB DACW41-75-B-0070, SCH.-A, ITEM 0001 & 0002

CONTRACT U.S. ARMY ENGR. P.O. DACW41-76-C-0044

Post Office Box 1995
705 N. Carlton
Telephone 466-3621
Stockton, California 95201

REV.	DESCRIPTION	CHK'D BY	DATE
7	AS BUILT DRAWING		5-29-87

DRAWN BY

CHKD. BY

DWG. NO. D53176-13

SCALE NONE

DATE 2-5-76